



EXTERNAL FRONT ELEVATION

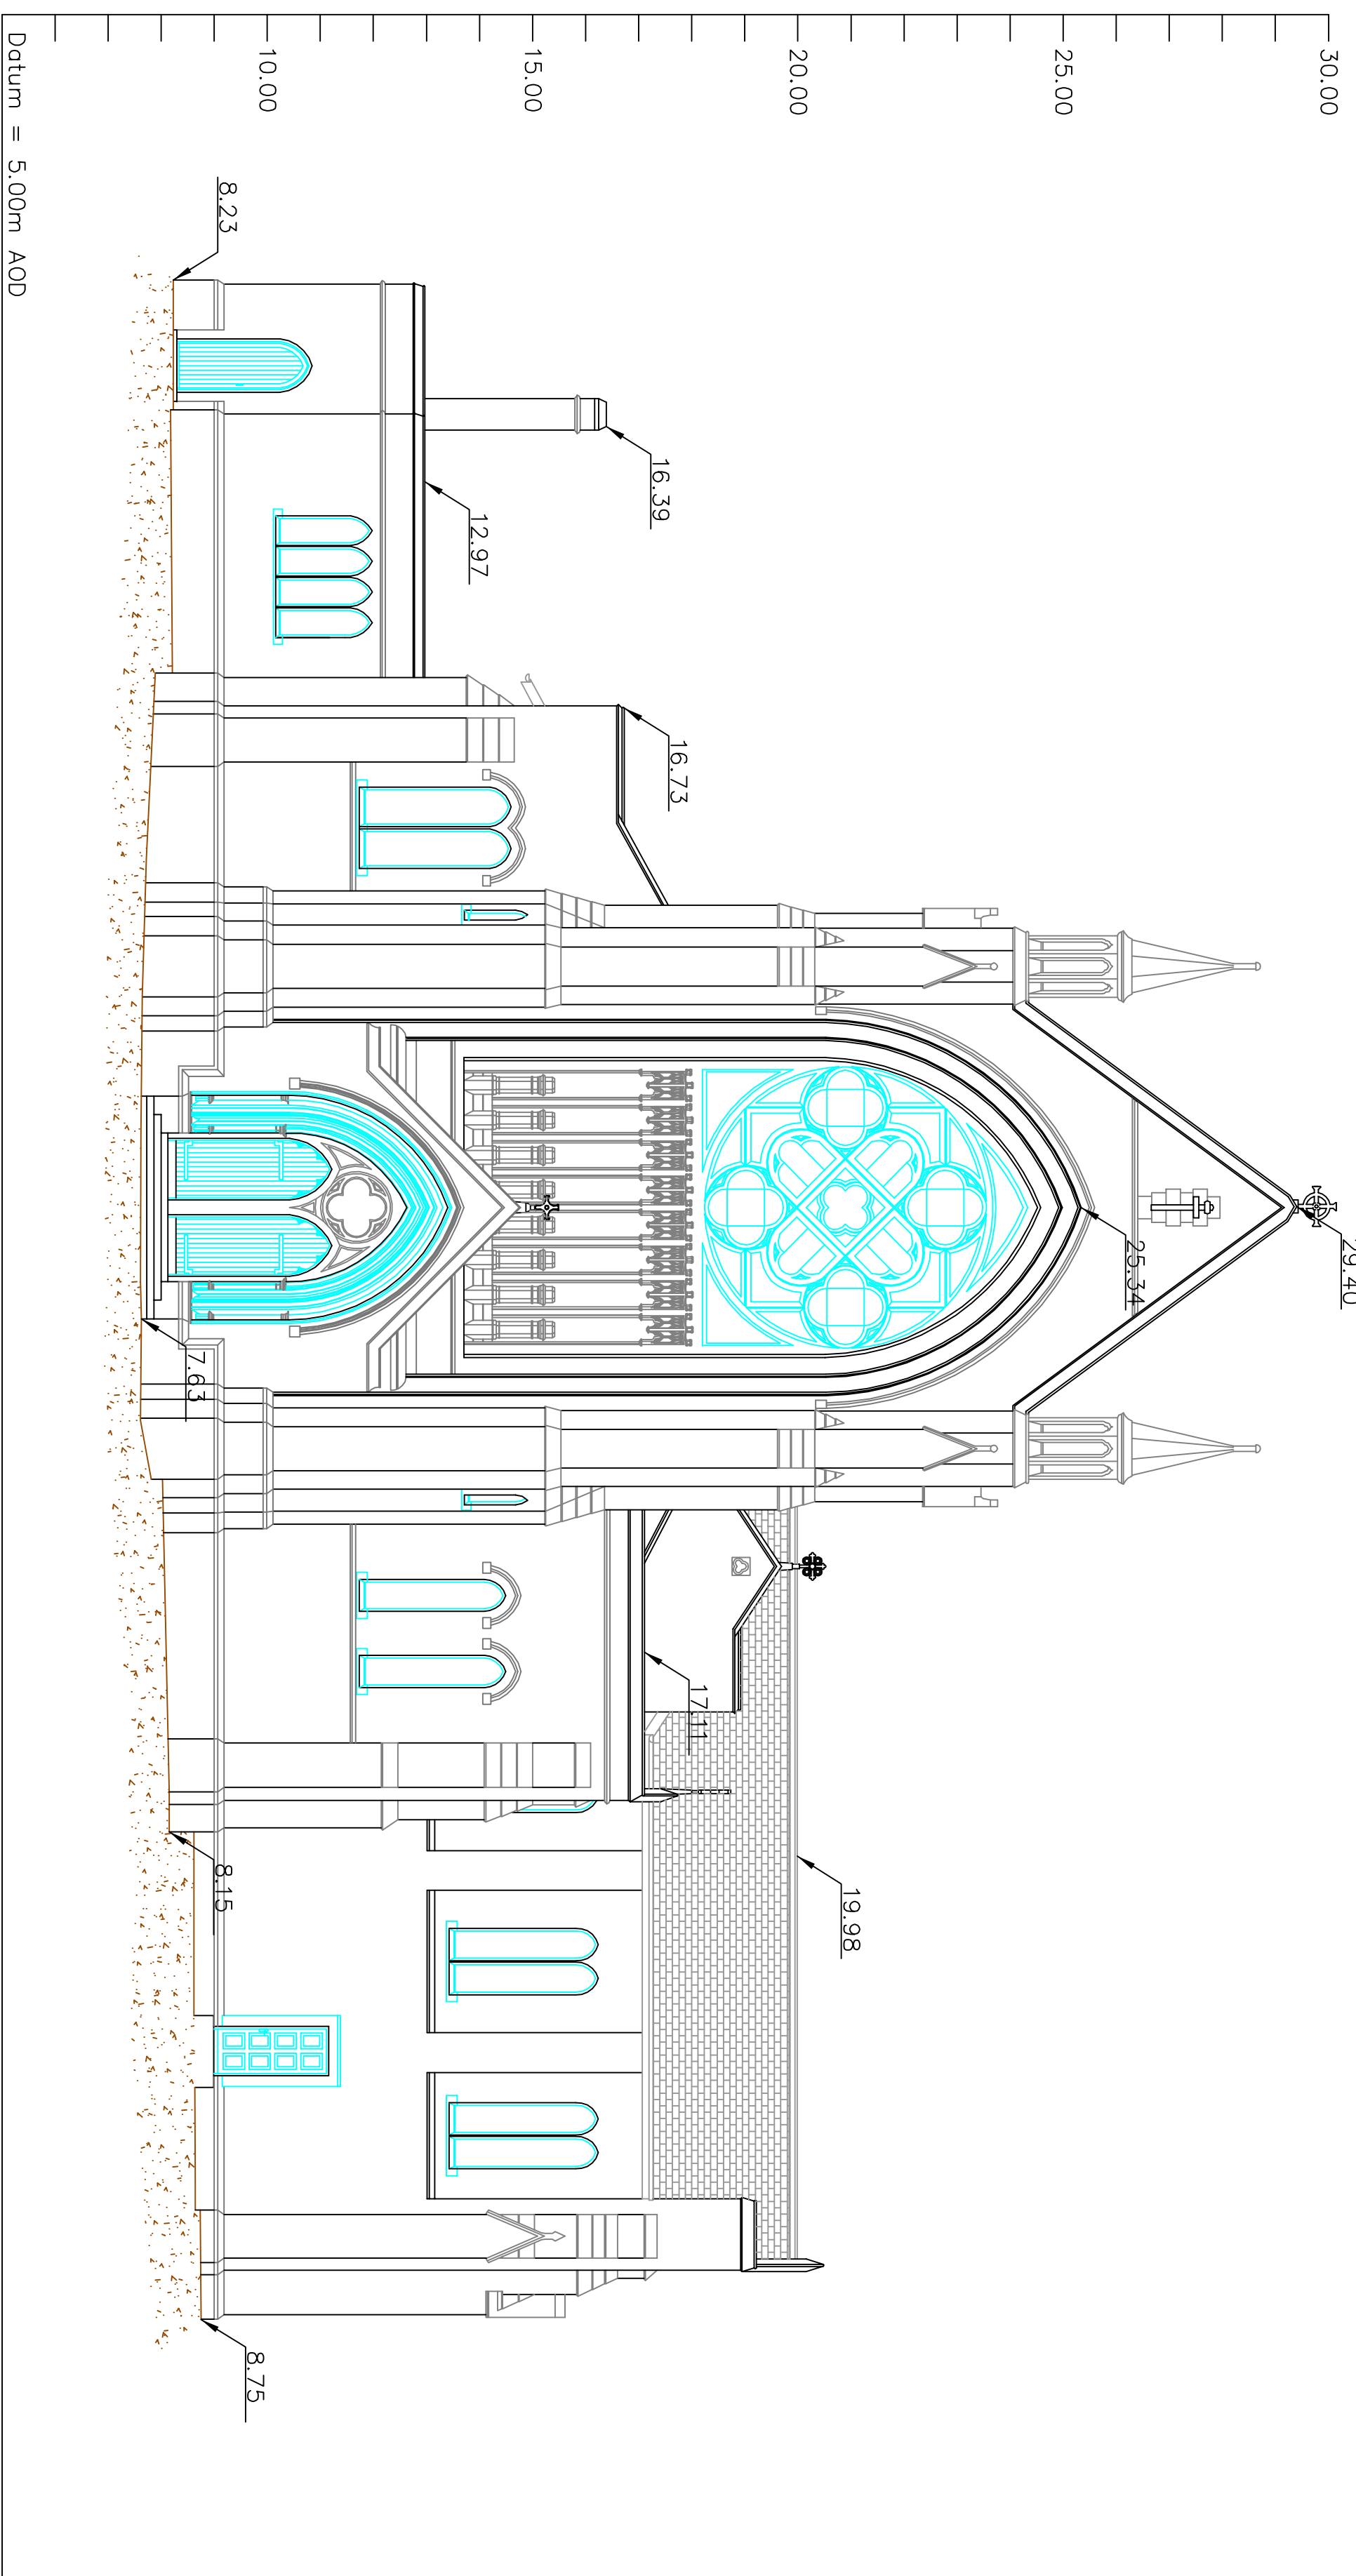

EXTERNAL SIDE ELEVATION A

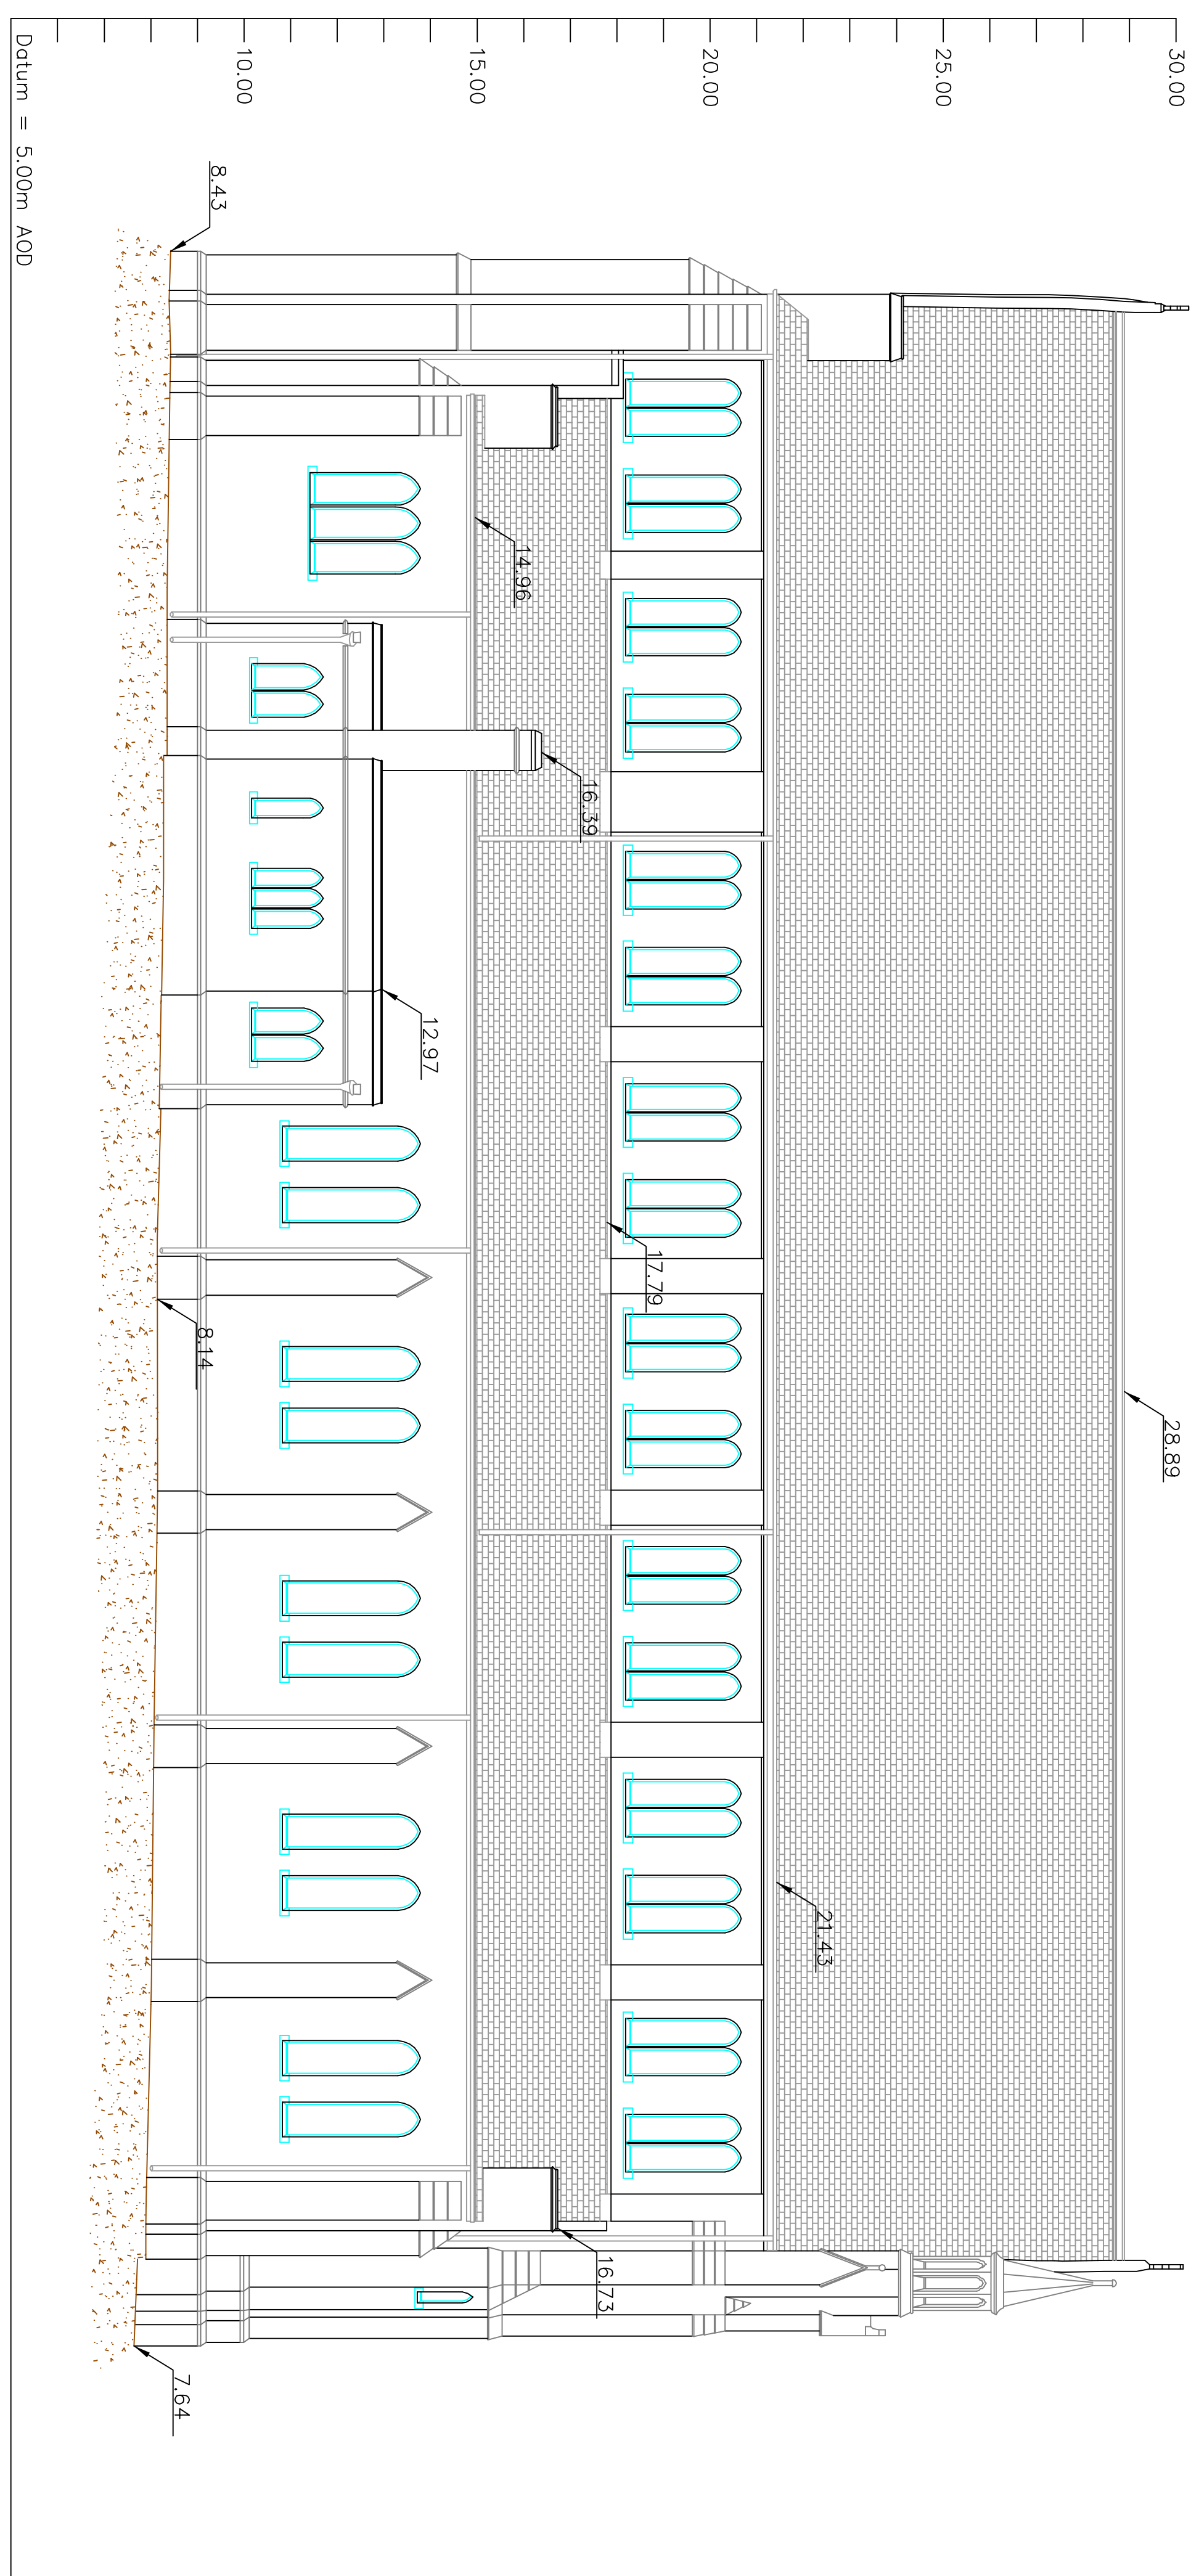

NOTES:  
1. All levels are relative to Ordnance Datum  
Main Head

| REVISIONS |      |
|-----------|------|
| No.       | Date |
|           |      |
|           |      |
|           |      |
|           |      |

**Control Surveys**  
land and building surveys

6 Oakenwood, Killybeggs, Donnybrook, Limerick.  
Tel: 087 2859112 email: [clm@controlsurveys.ie](mailto:clm@controlsurveys.ie)  
website: [www.controlsurveys.ie](http://www.controlsurveys.ie)

- Topographical Surveys
- Masonry Building Surveys
- As Built Surveys
- GIS Surveys
- Digital Mapping

**THE IRISH ENGINEERING BOARD**  
No. 542

**Client:** \_\_\_\_\_

**Professional:** \_\_\_\_\_

**Project Title:** \_\_\_\_\_

**Drawn:** \_\_\_\_\_ **Drawn No.:** \_\_\_\_\_

**Scale:** \_\_\_\_\_ **Date:** \_\_\_\_\_



1 : 100