FRONT ELEVATION

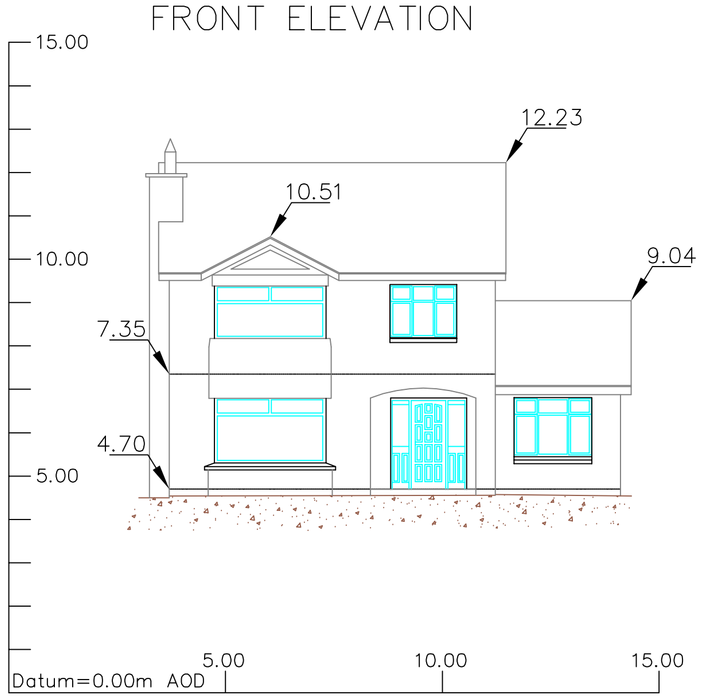

REAR ELEVATION

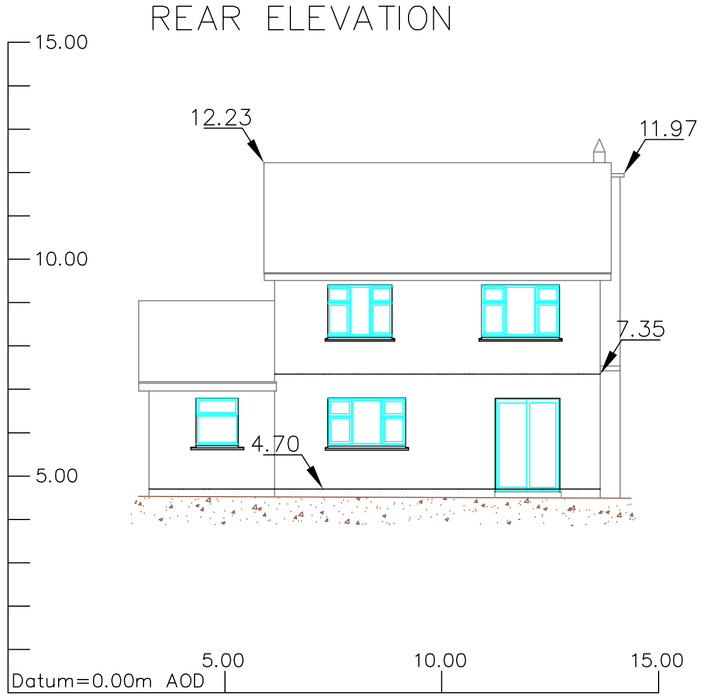

SIDE ELEVATION A

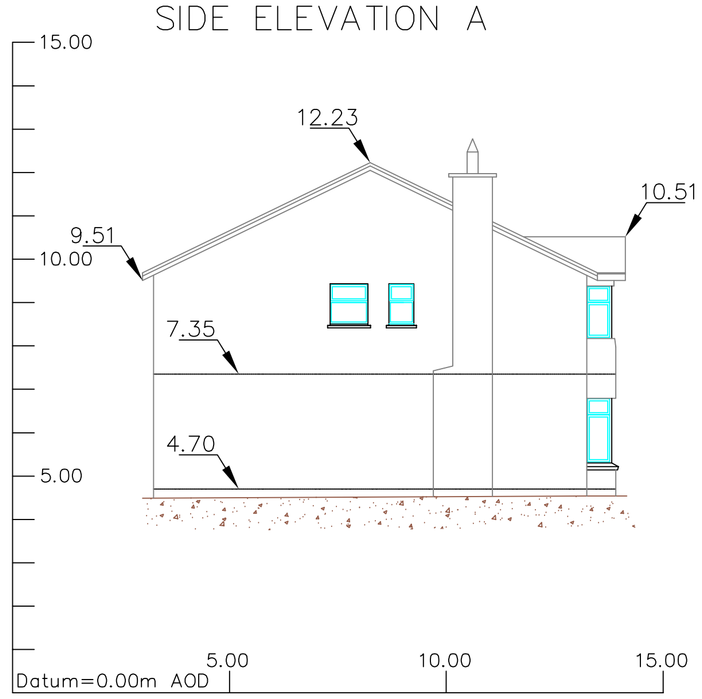

FRONT ELEVATION B

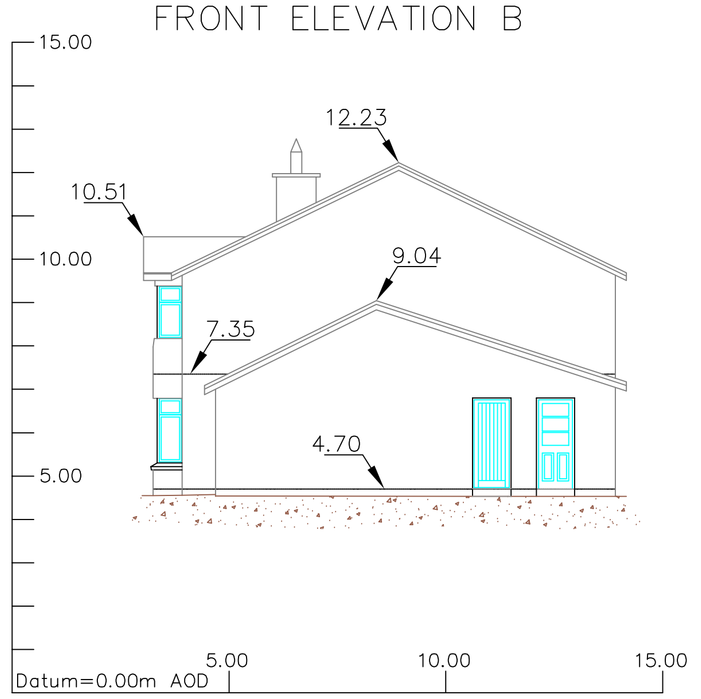

GRAPHIC SCALE

(IN METERS)

2 0 1 2 4 6 8 10

1 : 100

FIRST FLOOR PLAN

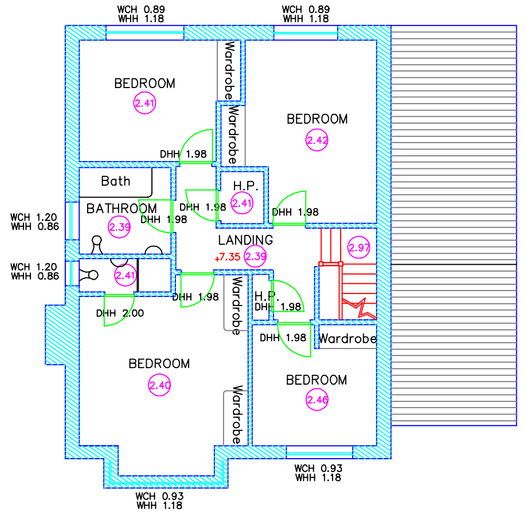

GROUND FLOOR PLAN

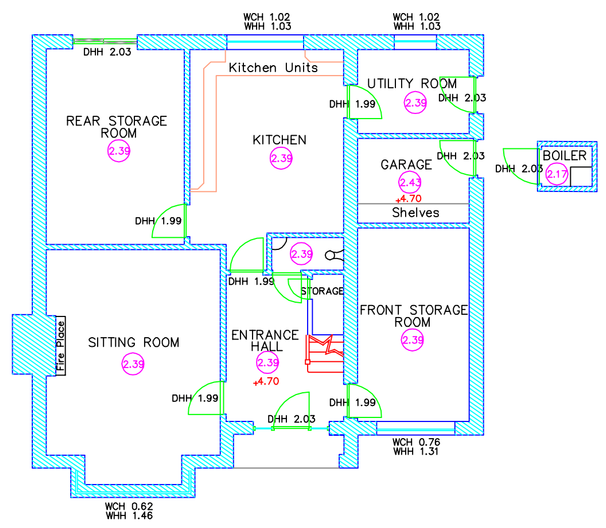

GRAPHIC SCALE

(IN METERS)

2 0 1 2 4 6 8 10

1 : 100

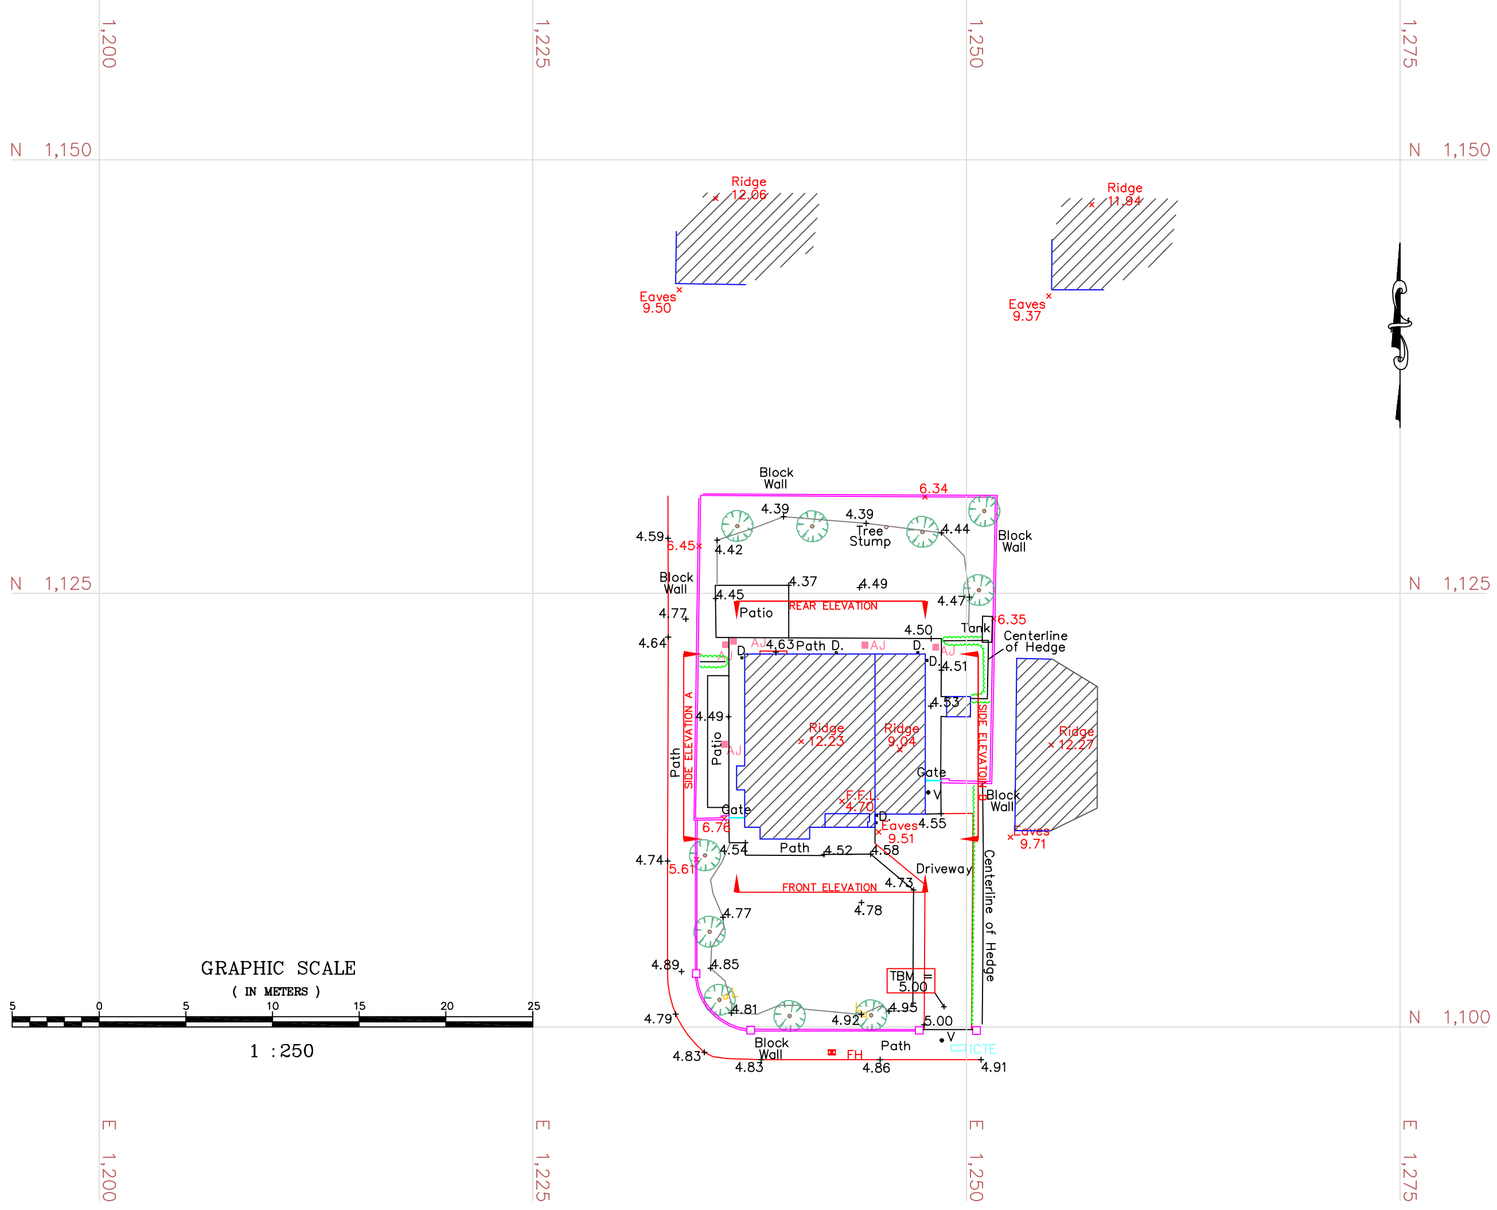

GRAPHIC SCALE

(IN METERS)

5 0 5 10 15 20 25

1 : 250

NOTES:
1. All levels are relative Temporary Benchmark as shown on drawing
   Value of TBM = 5.00m
2. Arbitrary 25m sq Grid

SYMBOL LEGEND

AV	Air Valve	SV	Sluice Valve
V	Valve	WV	Water Valve
FH	Fire Hydrant	WM	Water Meter
IC	Inspection Chamber	Post	Post
	Telecom Duct		ESB Duct
TE Box	Telecom Box	ESB Box	ESB Box
T	Tree	EP	ESB Pole
	Tree Spread	TP	Telecom Pole
	Bush/Shrub	LS	Lamp Standard
Sign	Sign	T Sign	Traffic Sign
AJ	Armstrong Junction	GY	Gully
ER	Earth Rod	Gas	Gas
TL	Traffic Light	B	Bollard
CATV	Cable TV Duct	Bin	Bin
G	Gate	Stay	Stay
ESB / TE / G	Manhole & Cover Level	Serv	Service
	Survey Station	Pipe	Pipe
Ridge 8.73	Ridge Height	Coping 8.73	Coping Height
FFL 8.73	Finished Floor Level	Gutter 8.73	Gutter Height
Eaves 8.73	Eaves Height	Roof 8.73	Roof Height
6.78	Boundary Height	8.55	Spot Height

LINE TYPE LEGEND

	Wall		Concrete Edge
	Fence		Centerline of Trees
	Footpath		Hedge
	Drain/River		Step
	Flower Bed		Plinth
	ESB Line		Telecom Line
	Mound		Mound Center
	Kerb		Road
11.00	Contour Major	10.75	Contour Minor
	Building		Plinth
	Bottom of Bank		Top of Bank
	Yellow Line		White Line

FLOOR PLAN LEGEND

WCH	Window Cill Height	DHH	Door Head Height
WHH	Window Head Height	USB	Underside of Beam
	Sink		Toilet
8.73	Floor to Ceiling Height	8.70	Floor Level

REVISIONS

No.	Date	Description

Control Surveys
land and building surveyors
No. 562
6 Crestwood, Kilteragh, Dooradoyle, Limerick.
Tel: 087 2659112 email: cian@controlsurveys.ie
website: www.controlsurveys.ie

- Topographical Surveys
- Measured Building Surveys
- Legal Mapping
- As Built Surveys
- GPS Surveys
- Setting Out

Client:

Professional:

Project Title:

Drawn: | **Dwg No:**

Scale: | **Date:**

PDF Created with deskPDF PDF Writer - Trial :: http://www.docudesk.com